

Date: Wednesday, 12/7/2005 12:45:31 PM
 User: Kim Johnston

Process Sheet

Customer : CU-DAR001 Dart Helicopters Services	Drawing Name : LOCK SHAFT R22
Job Number : 25168	
Estimate Number : 11269	
P.O. Number : N/A	Part Number : D33573
This Issue : 12/7/2005 S.O. No. : N/A	Drawing Number : D3357 REV D
Prsht Rev. : NC	Project Number : N/A
First Issue : N/A Type : MACHINED PARTS	Drawing Revision : D
Previous Run : N/A	Material : N/A
Written By : <u>SEE COMMENT BELOW</u>	Due Date : 1/10/2006 Qty: 10 Um: Each
Checked & Approved By : <u>SEE COMMENT BELOW</u>	
Comment : Est Rev:A 05.09.13 New issue KJ/JLM	

Additional Product

Job Number:



Seq. #:	Machine Or Operation:	Description :
----------------	------------------------------	----------------------

1.0	M174R1000	17-4PH SS ROUND BAR 1.00
-----	-----------	--------------------------



Comment: Qty.: 0.3534 f(s)/Unit Total : 3.5343 f(s)
 17-4PH SS ROUND BAR 1.00
 (M174R0100)
 Batch: M19430

ML 06/01/27

10

2.0	HARDINGE	HARDINGE CNC LATHE SMALL
-----	----------	--------------------------



Comment: HARDINGE CNC LATHE SMALL

1-Turn as per Folio FA504 and Dwg D3357

2-Deburr

ML 06/01/27

10

3.0	QC2	INSPECT PARTS AS THEY COME OFF MACHINE
-----	-----	--



Comment: INSPECT PARTS AS THEY COME OFF MACHINE

ML 06/01/27

10

4.0	MILLING CONV.	CONVENTIONAL MILLING MACHINE
-----	---------------	------------------------------



Comment: CONVENTIONAL MILLING MACHINE

Mill as per Dwg D3357

ML 06/02/05

10

5.0	QC2	INSPECT PARTS AS THEY COME OFF MACHINE
-----	-----	--



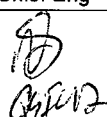
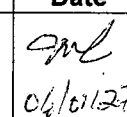
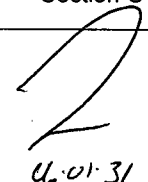
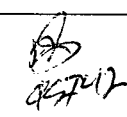
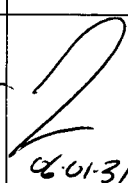
Comment: INSPECT PARTS AS THEY COME OFF MACHINE

ML 06/02/05

10

W/O:		WORK ORDER CHANGES					
DATE	STEP	PROCEDURE CHANGE	By	Date	Qty	Approval Chief Eng / Prod Mgr	Approval QC Inspector

Part No: _____ PAR #: _____ Fault Category: _____ NCR: Yes ☒ No ☐ DQA: LD Date: 06/02/07
 QA: N/C Closed: _____ Date: _____

NCR:		WORK ORDER NON-CONFORMANCE (NCR)						
DATE	STEP	Description of NC Section A	Corrective Action Section B			Verification Section C	Approval Chief Eng	Approval QC Inspector
			Initial Chief Eng	Action Description Chief Eng	Sign & Date			
06/01/27	2	one piece scrap thread too tight	 06/01/27	destroy and replace	 06/01/27	 06-01-31	 06/01/27	 06-01-31

NOTE: Date & initial all entries

Date: Wednesday, 12/7/2005 12:45:32 PM
User: Kim Johnston

Process Sheet

Customer: CU-DAR001 Dart Helicopters Services

Drawing Name: LOCK SHAFT R22

Job Number: 25168

Part Number: D33573

Job Number:



Seq. #:

Machine Or Operation:

Description :

6.0

QC8

SECOND CHECK



Comment: SECOND CHECK

MS 06/02/05

10

7.0

PACKAGING 1

PACKAGING RESOURCE #1



Comment: PACKAGING RESOURCE #1

Identify and Stock

Location: 419

CY 06/02/06

10

8.0

DC

DOCUMENT CONTROL



Comment: DOCUMENT CONTROL

Inspection Level 21

SUR 06/02/07

(10)

DD 06/02/07

(10)

Job Completion



W/O:		WORK ORDER CHANGES					
DATE	STEP	PROCEDURE CHANGE	By	Date	Qty	Approval Chief Eng / Prod Mgr	Approval QC Inspector

Part No: _____ PAR #: _____ Fault Category: _____ NCR: Yes No DQA: _____ Date: _____

QA: N/C Closed: _____ Date: _____

NCR:		WORK ORDER NON-CONFORMANCE (NCR)						
DATE	STEP	Description of NC Section A	Corrective Action Section B			Verification Section C	Approval Chief Eng	Approval QC Inspector
			Initial Chief Eng	Action Description Chief Eng	Sign & Date			

NOTE: Date & initial all entries

DART AEROSPACE LTD	Work Order:	25168
Description: Lock Shaft (R22)	Part Number:	D3357-3
Inspection Dwg: D3357 Rev: C		Page 1 of 1

FIRST ARTICLE INSPECTION CHECKLIST

☒ **First Article** ☐ **Prototype**

[illegible]

Measured by:	gsh/	Audited by:	MS	Prototype Approval:	N/A
Date:	06/01/27	Date:	06/01/27	Date:	N/A

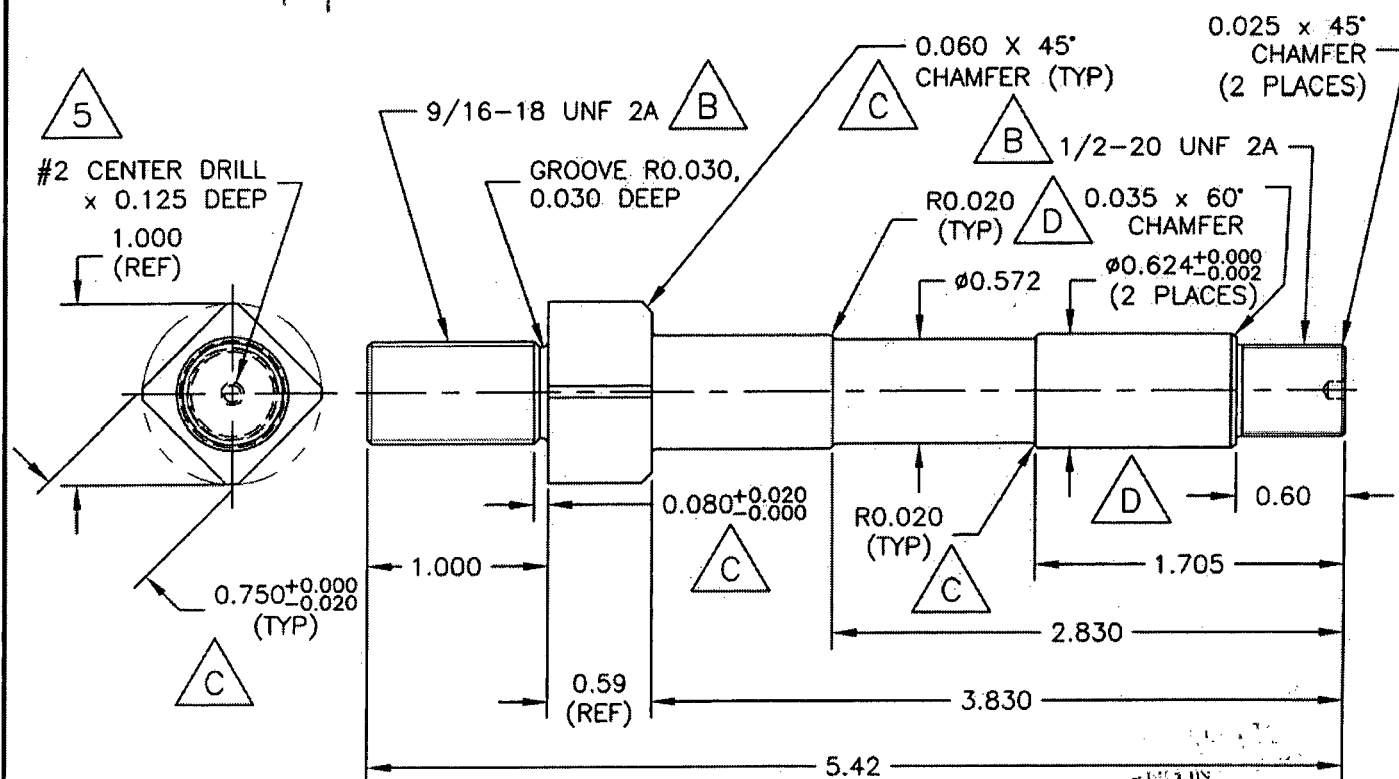
Rev	Date	Change	Revised by	Approved
A	05.04.26	New Issue	KJ/JLM	
B	05.09.13	Dimensions & tolerances revised per D3357 Rev. C	KJ/JLM	

DART

DESIGN <i>[Signature]</i>	DRAWN BY <i>[Signature]</i>	DART AEROSPACE LTD HAWKESBURY, ONTARIO, CANADA	
CHECKED <i>[Signature]</i>	APPROVED	DRAWING NO. D3357	REV. D SHEET 1 OF 3
DATE 05.12.02		TITLE SHAFTS	SCALE 1:1
A	04.12.13	NEW ISSUE	
B	05.05.27	ADD THREAD SPEC & 0.063; 17-4 PH ROUND WAS 303 HEX SS	
C	05.07.21	0.750 WAS 0625; 0.100 WAS 0.063	
D	05.12.02	Ø0.624 WAS Ø0.623; 0.60 WAS 0.71	

RELEASED

05/12/02

**D3357-1 R22/R44 WHEEL SHAFT**CONTROL COPY
SUBJECT TO AGREEMENT
WITHOUT NOTICE

WORK ORDER

NO. 25168

NOTES:

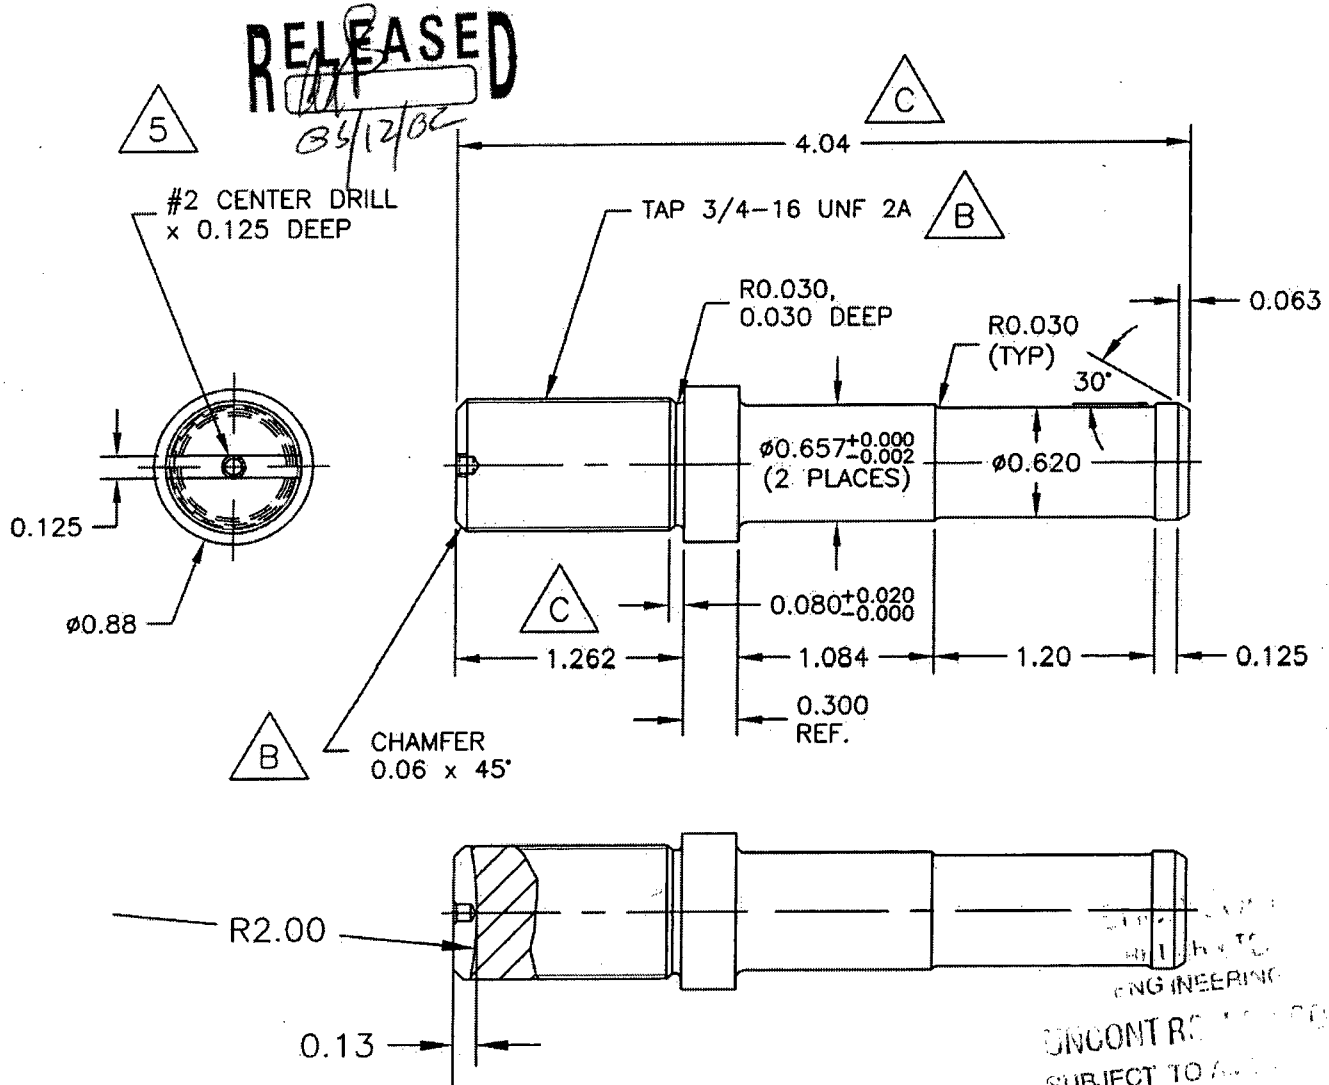
- 1) MATERIAL: 17-4 PH ROUND BAR STAINLESS STEEL CONDITION H900 (REF. DART SPEC. M17-4-R1.000)
- 2) TOLERANCES ARE PER DART QSI 018 UNLESS OTHERWISE NOTED
- 3) ALL DIMENSIONS ARE INCHES
- 4) BREAK ALL SHARP EDGES 0.005 TO 0.010
- 5) CENTER DRILL AS REQUIRED

Copyright © 2004 by DART AEROSPACE LTD

THIS DOCUMENT IS PRIVATE AND CONFIDENTIAL AND IS SUPPLIED ON THE EXPRESS CONDITION THAT IT IS NOT TO BE USED FOR ANY PURPOSE OR COPIED OR COMMUNICATED TO ANY OTHER PERSON WITHOUT WRITTEN PERMISSION FROM DART AEROSPACE LTD.

DART

DESIGN <i>[Signature]</i>	DRAWN BY <i>[Signature]</i>	DART AEROSPACE LTD HAWKESBURY, ONTARIO, CANADA	
CHECKED <i>[Signature]</i>	APPROVED	DRAWING NO. D3357	REV. D SHEET 2 OF 3
DATE 05.12.02		TITLE SHAFTS	SCALE 1:1

**D3357-3 R22 LOCK SHAFT****NOTES:**

- 1) MATERIAL: 17-4 PH ROUND BAR STAINLESS STEEL CONDITION H900
(REF. DART SPEC. M17-4-R1.000)
- 2) TOLERANCES ARE PER DART QSI 018 UNLESS OTHERWISE NOTED
- 3) ALL DIMENSIONS ARE INCHES
- 4) BREAK ALL SHARP EDGES 0.005 TO 0.010
- 5) CENTER DRILL AS REQUIRED

UNCONTROLLED
SUBJECT TO APPROVAL
WITHOUT NOTICE

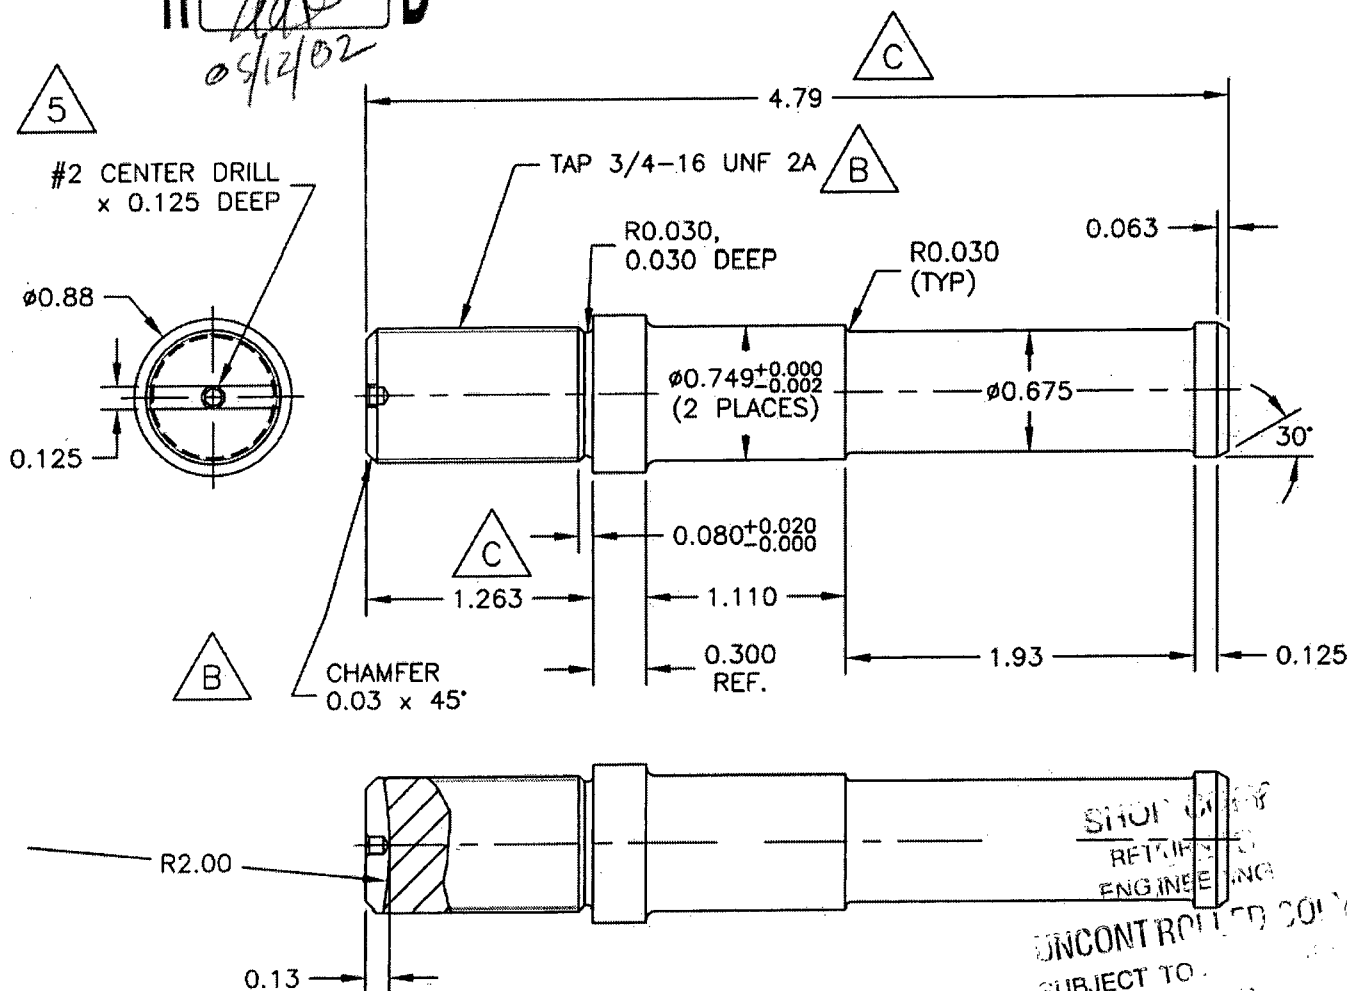
WORK ORDER
NO. 25168

Copyright © 2004 by DART AEROSPACE LTD

THIS DOCUMENT IS PRIVATE AND CONFIDENTIAL AND IS SUPPLIED ON THE EXPRESS CONDITION THAT IT IS NOT TO BE USED FOR ANY PURPOSE OR COPIED OR COMMUNICATED TO ANY OTHER PERSON WITHOUT WRITTEN PERMISSION FROM DART AEROSPACE LTD.

DART

DESIGN <i>[Signature]</i>	DRAWN BY <i>[Signature]</i>	DART AEROSPACE LTD HAWKESBURY, ONTARIO, CANADA	
CHECKED <i>[Signature]</i>	APPROVED	DRAWING NO. D3357	REV. D SHEET 3 OF 3
DATE 05.12.02		TITLE SHAFTS	SCALE 1:1

RELEASED
[Signature]
05/2/02**D3357-5 R44 LOCK SHAFT****NOTES:**

- 1) MATERIAL: 17-4 PH ROUND BAR STAINLESS STEEL CONDITION H900
(REF. DART SPEC. M17-4-R1.000)
- 2) TOLERANCES ARE PER DART QSI 018 UNLESS OTHERWISE NOTED
- 3) ALL DIMENSIONS ARE INCHES
- 4) BREAK ALL SHARP EDGES 0.005 TO 0.010
- 5) CENTER DRILL AS REQUIRED

Copyright © 2004 by DART AEROSPACE LTD

THIS DOCUMENT IS PRIVATE AND CONFIDENTIAL AND IS SUPPLIED ON THE EXPRESS CONDITION THAT IT IS NOT TO BE USED FOR ANY PURPOSE OR COPIED OR COMMUNICATED TO ANY OTHER PERSON WITHOUT WRITTEN PERMISSION FROM DART AEROSPACE LTD.